

**Wildlife and Countryside Act 1981  
Section 53(2)(b)**

**Definitive Map Modification (Public  
Byway Open to All Traffic 21, Crowle)  
Order 2003(2)**

**West Riding of Yorkshire (Thorne Rural  
District) Definitive Map and Statement**



## Wildlife and Countryside Act 1981

### West Riding of Yorkshire (Thorne Rural District) Definitive Map and Statement

#### Definitive Map Modification (Public Byway Open to All Traffic 21, Crowle) Order 2003(2)

This order is made by North Lincolnshire Council under section 53(2)(b) of the Wildlife and Countryside Act 1981 ("the Act") because it appears to that authority that the West Riding of Yorkshire Definitive Map and Statement (Thorne Rural District) require modification in consequence of the occurrence of an event specified in section 53(3)(c)(i) – namely, the discovery by the authority of evidence which (when considered with all other relevant evidence available to them) shows that a right of way which is not shown in the map and statement subsists or is reasonably alleged to subsist over land in the area to which the map relates, being a right of way to which this Part applies – of the Act.

The authority have consulted every local authority whose area includes the land to which the order relates. North Lincolnshire Council hereby order that:

1. For the purposes of this order the relevant date is 27<sup>th</sup> March 2003.
2. The West Riding of Yorkshire (Thorne Rural District) Definitive Map and Statement shall be modified as described in Part One and Part Two of the Schedule and shown on the map attached to the order.
3. This order shall take effect on the date it is confirmed and may be cited as the Definitive Map Modification (Public Byway Open to All Traffic 21, Crowle) Order 2003(2).

#### SCHEDULE

##### PART 1

##### Modification of Definitive Map

##### *Description of way to be added*

A 1,004-metre-long byway open to all traffic <sup>having a width of 12.19 metres (40 feet)</sup> ~~of a maximum width of 8 metres~~ over a well-defined track throughout leading in a north-easterly direction along the north-western edge of Crook O' Moor Drain from Point A (grid reference SE7472412279) immediately north of the Stainforth and Keadby Canal at the Medge Hall canal-and-railway crossing to Point B (grid reference SE7538813024) at its junction with the southernmost end of Yorkshire Moors Bottom Road as indicated on the map.

PART 2

Modification of Definitive Statement

*Variation of particulars or way*  
having a width of 12.19 metres (40 feet)

A 1,004-metre-long byway open to all traffic of a ~~maximum width of 8 metres~~ over a well-defined track throughout leading in a north-easterly direction along the north-western edge of Crook O' Moor Drain from Point A (grid reference SE7472412279) immediately north of the Stainforth and Keadby Canal at the Medge Hall canal-and-railway crossing to Point B (grid reference SE7538813024) at its junction with the southernmost end of Yorkshire Moors Bottom Road as indicated on the map.

The foregoing order is hereby confirmed  
subject to the red ink modifications thereon

*Mark Yates*

An Inspector appointed by The Secretary of  
State for Environment, Food and  
Rural Affairs


09 OCT 2006



The COMMON SEAL of  
NORTH LINCOLNSHIRE COUNCIL  
was hereunto affixed  
in the presence of:

Dated: *L. A. [Signature]*  
3rd April 2003

Seal Number: 3432

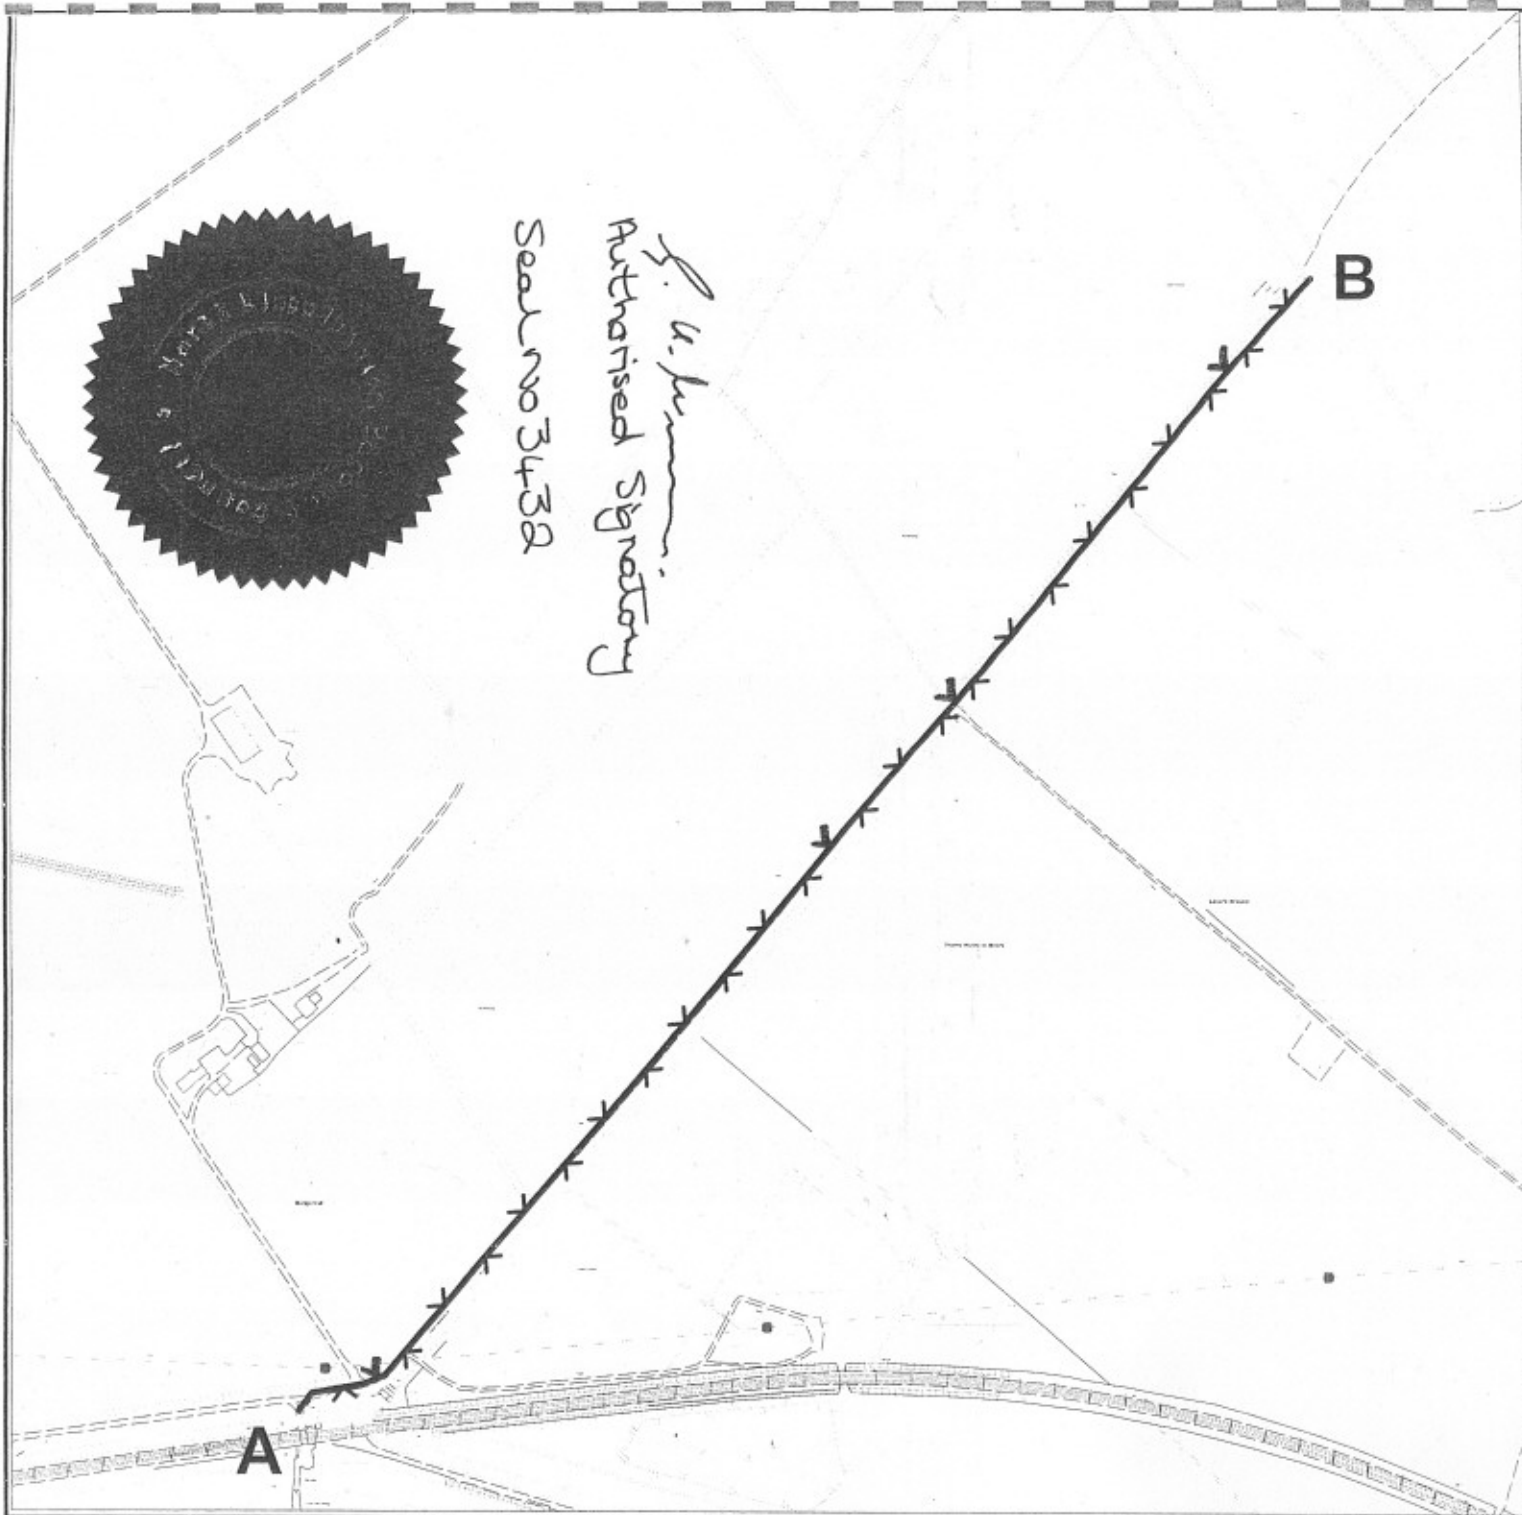

**A4** Printer Frame  
Map Area 196mm / 198mm

Notes

--	--	--	--	--

Rev No	Revision Details	Rev'd By	Rev Date
--------	------------------	----------	----------



Directorate of Environment and Public Protection

Environment Team

Director, E. Lodge, BA, DMA, MCIEH, MinstWM, MIHE

Project Title  
Crowle B.O.A.T 21

Drawing Title  
Crook O' Moor Road

Drawn by; \_\_\_\_\_ Date; \_\_\_\_\_

SCALE; 1:5,000 App'd by; \_\_\_\_\_

Based upon the Ordnance Survey mapping with the permission of Ordnance Survey on behalf of the Controller of Her Majesty's Stationery Office.  
© Crown Copyright.

Unauthorised reproduction infringes Crown Copyright and may lead to prosecution or civil proceedings.  
NORTH LINCOLNSHIRE COUNCIL LA09062L 2003