

**Wildlife and Countryside Act 1981
Section 53**

**County of Lincoln – Parts of Lindsey
(Glanford Brigg) Definitive Map and
Statement**

**Definitive Map Modification (Public
Footpath 38, Barton-upon-Humber)
Order 2004(1)**



Wildlife and Countryside Act 1981

County of Lincoln – Parts of Lindsey (Glanford Brigg) Definitive Map and Statement

Definitive Map Modification (Public Footpath 38, Barton-upon-Humber) Order 2004(1)

This order is made by North Lincolnshire Council under section 53(2)(b) of the Wildlife and Countryside Act 1981 ("the Act") because it appears to that authority that the County of Lincoln – Parts of Lindsey (Glanford Brigg) Definitive Map and Statement require modification in consequence of the occurrence of an event specified in section 53(3)(c)(i) – namely, the discovery by the authority of evidence, which (when considered with all other relevant evidence available to them) shows that a right of way that is not shown in the map and statement subsists or is reasonably alleged to subsist over land in the area to which the map relates, being a right of way to which this Part applies – of the Act.

The authority have consulted every local authority whose area includes the land to which the order relates. North Lincolnshire Council hereby order that:

1. For the purposes of this order the relevant date is 24th August 2004.
2. The County of Lincoln – Parts of Lindsey (Glanford Brigg) Definitive Map and Statement shall be modified as described in Part 1 and Part 2 of the Schedule and shown on the map attached to the order.
3. This order shall take effect on the date that it is confirmed and may be cited as the Definitive Map Modification (Public Footpath 38, Barton-upon-Humber) Order 2004(1).

The foregoing order is hereby confirmed subject to the red ink modifications thereon

SCHEDULE

PART 1



An Inspector appointed for the purpose by the Secretary of State for Environment, Food and Rural Affairs

Modification of Definitive Map

20 JUN 2006

Description of path to be added

A – B, as indicated on the map: a 112-metre-long footpath commencing on Barrow Road at grid reference TA0349821756 and proceeding in a north-easterly direction over a width of approximately 1.8 metres along the western flank or pavement of the street known as Green Lane to the northern end of Green Lane at a point adjacent to the north-east corner of Number Nine, Green Lane, at grid reference TA0353221864.

B – C, as indicated on the map: a 73-metre-long footpath commencing at the northern end of Green Lane at a point adjacent to the north-east corner of Number 9, Green Lane, at grid reference TA0353221864 and proceeding in a north-westerly direction over a width of between ~~approximately five~~ 5 and 6.5 metres (1.5 metres of which is tarmacked) to a point just within the eastern perimeter of St. Peter's churchyard at grid reference TA0348521917 by way of a gap in a wall of at least one metre.

C – D, as indicated on the map: a 75-metre-long footpath commencing at a point just within the eastern perimeter of St. Peter's churchyard at grid reference TA0348521917 and proceeding in a west-north-westerly direction along a tarmacked path of a width of ~~approximately~~ 1.8 metres through the churchyard to the south of the church and then passing between the Old Vicarage to the north and the Vicarage to the south to join Beck Hill at the north-west corner of the Vicarage at grid reference TA0341021930.

PART 2

Modification of Definitive Statement

Variation of particulars of path


A 260-metre-long footpath commencing on Barrow Road at grid reference TA0349821756 and proceeding in a north-easterly direction for 112 metres along the western flank or pavement of the street known as Green Lane over a width of ~~approximately~~ 1.8 metres to the northern end of Green Lane at a point adjacent to the north-east corner of Number Nine, Green Lane, at grid reference TA0353221864; then continuing for a further 73 metres in a north-westerly direction over a width of between ~~approximately five~~ 5 and 6.5 metres to a point just within the eastern perimeter of St. Peter's churchyard at grid reference TA0348521917 by way of a gap in a wall of at least one metre; then continuing for a further 75 metres in a west-north-westerly direction along a tarmacked path of a width of ~~approximately~~ 1.8 metres through the churchyard to the south of the church and then passing between the Old Vicarage to the north and the Vicarage to the south to join Beck Hill at the north-west corner of the Vicarage at grid reference TA0341021930.


The COMMON SEAL of
NORTH LINCOLNSHIRE COUNCIL
was hereunto affixed in the presence of:

M Ward
Authorised signatory:

Dated: *2nd September 2004*

Seal Number: *4258*

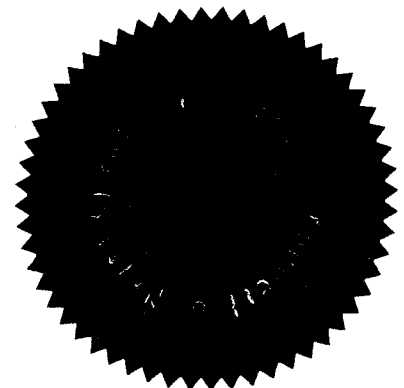

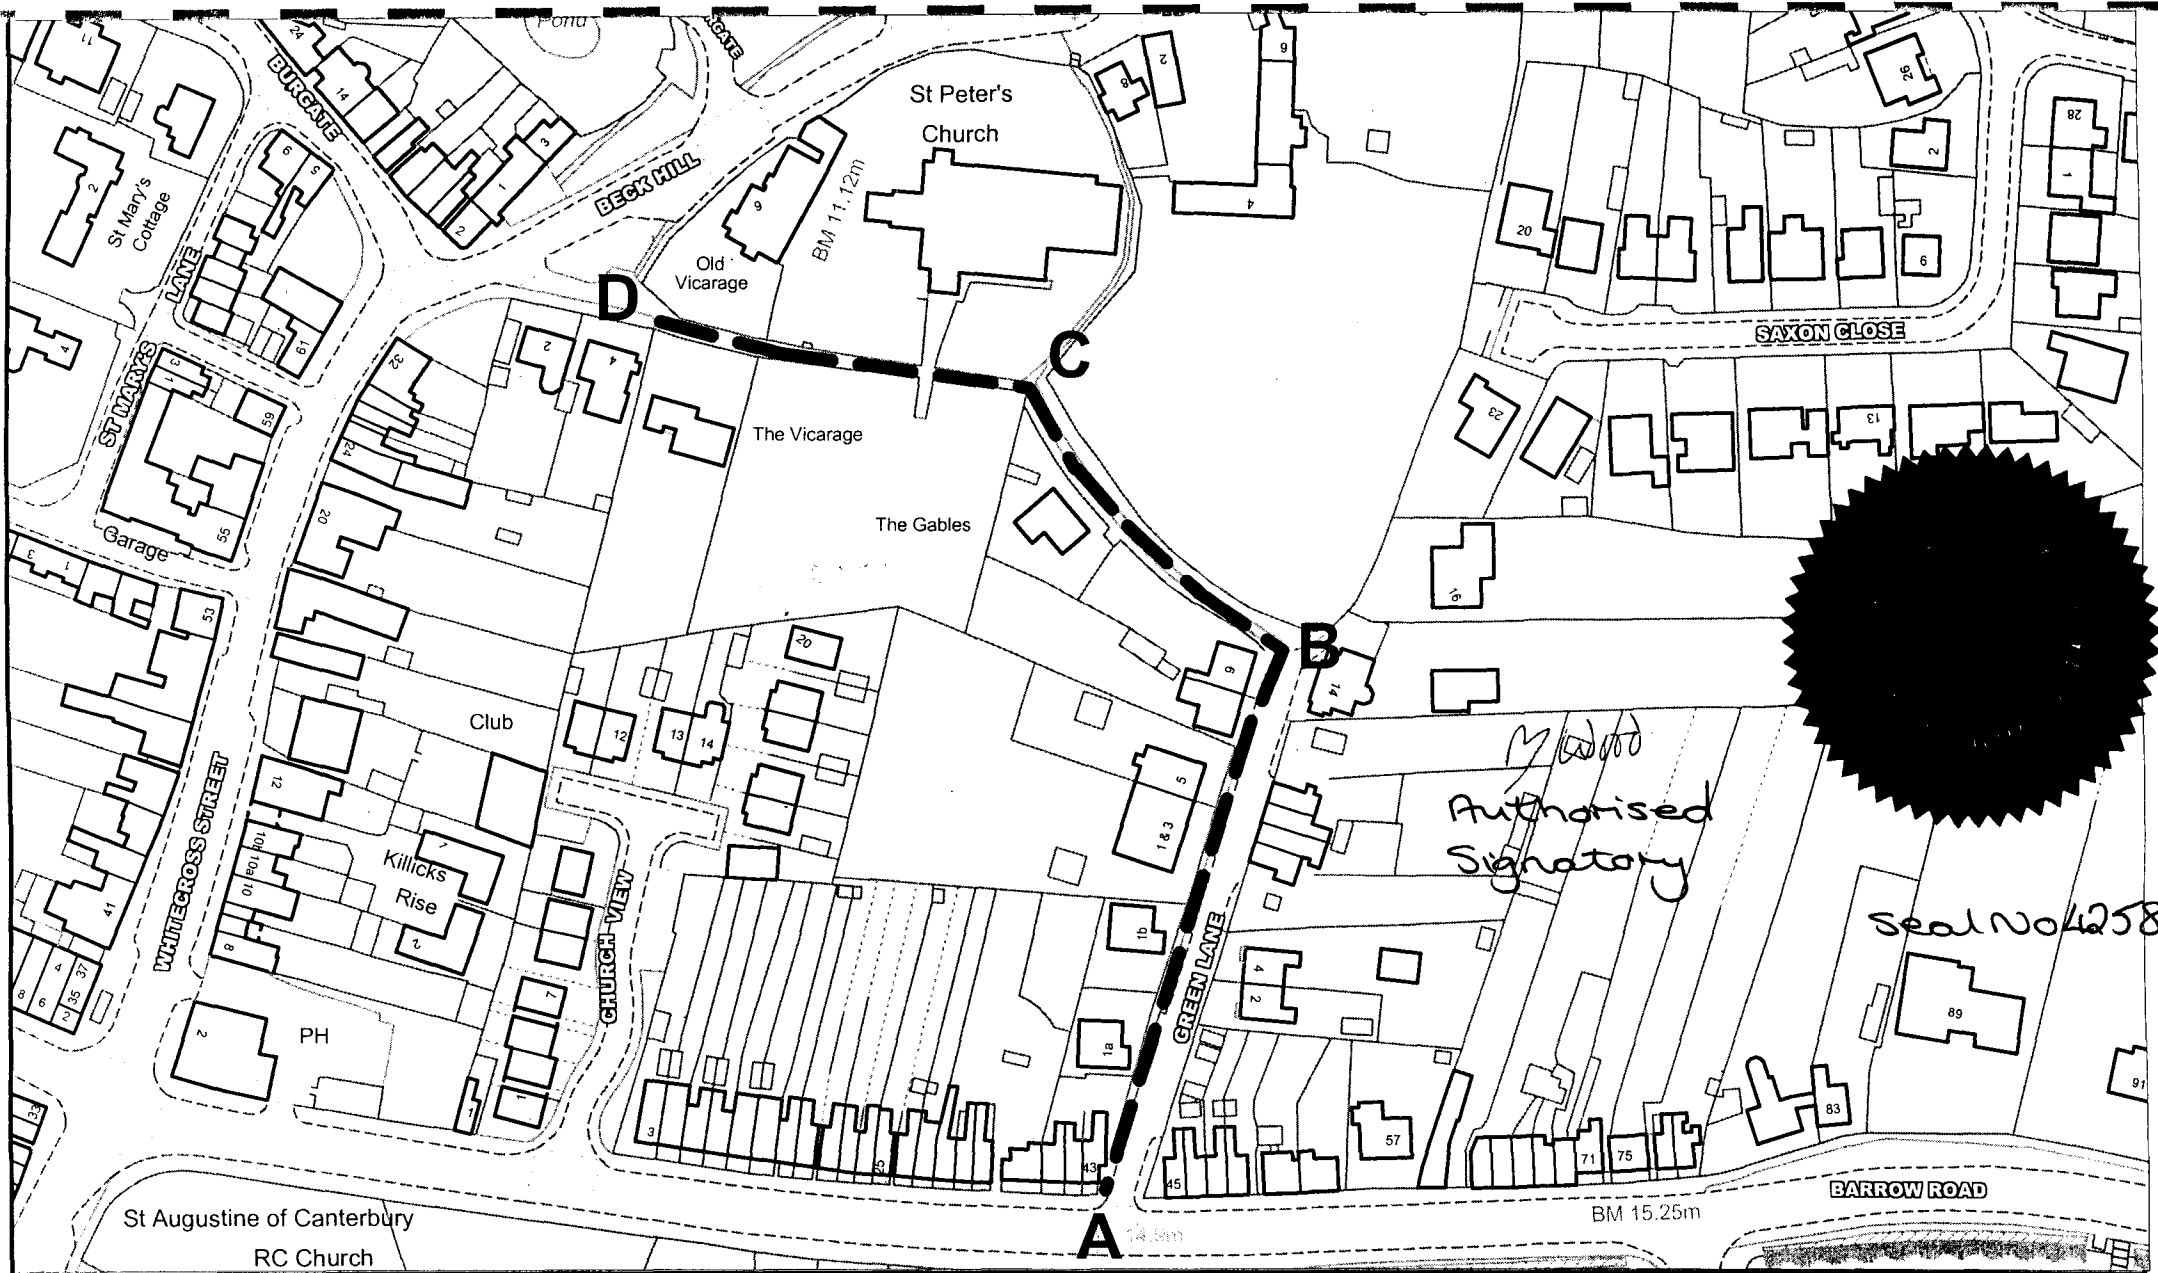

M. Wood
 Authorised
 Signatory

Seal No 4258



Based upon the Ordnance Survey mapping with the permission of Ordnance Survey on behalf of the Controller of Her Majesty's Stationery Office.
 © Crown Copyright.

Unauthorised reproduction infringes Crown Copyright and may lead to prosecution or civil proceedings.

NORTH LINCOLNSHIRE COUNCIL 100013349 2004

Drawing Title: Public Footpath 38, Barton-upon-Humber

Drawn by: CTW

Scale: 1:1,500

Date: 27/08/2004



Planning and Regeneration Service

Head of Service,

T Lyman BSc(Hons), DipTP, MRTPI

The Ordnance Survey map data included within this publication is provided by North Lincolnshire Council under license from Ordnance Survey in order to fulfil its public function to act as a planning authority. Persons viewing this mapping should contact Ordnance Survey copyright for advice where they wish to license Ordnance Survey map data for their own use.