

**Wildlife and Countryside Act 1981
Section 53**

**County of Lincoln – Parts of Lindsey
(Glanford Brigg) Definitive Map and
Statement**

**Definitive Map Modification (Public
Footpath 38A, Barton-upon-Humber)
Order 2004(1)**



Wildlife and Countryside Act 1981

County of Lincoln – Parts of Lindsey (Glanford Brigg) Definitive Map and Statement

Definitive Map Modification (Public Footpath 38A) Order 2004(1)

This order is made by North Lincolnshire Council under section 53(2)(b) of the Wildlife and Countryside Act 1981 ("the Act") because it appears to that authority that the County of Lincoln – Parts of Lindsey (Glanford Brigg) Definitive Map and Statement require modification in consequence of the occurrence of an event specified in section 53(3)(c)(i) – namely, the discovery by the authority of evidence, which (when considered with all other relevant evidence available to them) shows that a right of way that is not shown in the map and statement subsists or is reasonably alleged to subsist over land in the area to which the map relates, being a right of way to which this Part applies – of the Act.

The authority have consulted every local authority whose area includes the land to which the order relates. North Lincolnshire Council hereby order that:

1. For the purposes of this order the relevant date is 27th August 2004.
2. The County of Lincoln – Parts of Lindsey (Glanford Brigg) Definitive Map and Statement shall be modified as described in Part 1 and Part 2 of the Schedule and shown on the map attached to the order.
3. This order shall take effect on the date that it is confirmed and may be cited as the Definitive Map Modification (Public Footpath 38^A, Barton-upon-Humber) Order 2004(1).
↑

SCHEDULE

PART 1

Modification of Definitive Map

Description of path to be added

A – B, as indicated on the map: a 75-metre-long footpath commencing on Beck Hill at grid reference TA0349421983 and ascending to St. Peter's churchyard by way of five steps to continue in a generally southerly direction over a width of approximately one metre alongside the inside perimeter of the churchyard in a clockwise direction, passing behind and beside the eastern side of the church and beyond to meet and connect with the footpath from Green Lane at grid reference TA0348521917.

PART 2

Modification of Definitive Statement

Variation of particulars of path

A 75-metre-long footpath commencing on Beck Hill at grid reference TA0349421983 that ascends via five steps to St. Peter's churchyard and proceeds southwards in a clockwise direction round the inside eastern perimeter of the churchyard over ~~an approximately~~ one-metre-wide footpath that is tarmacked (save for where it passes to the east of the church where it is flagged instead) to a point still just inside the eastern perimeter of the churchyard just to the north of the most northerly point of a property known as The Gables at grid reference TA0348521917 where it joins the footpath from Green Lane.


The COMMON SEAL of
NORTH LINCOLNSHIRE COUNCIL
was hereunto affixed
in the presence of:

M Wood

Authorised signatory:

Dated: *2nd September 2004*

Seal Number: *4259*

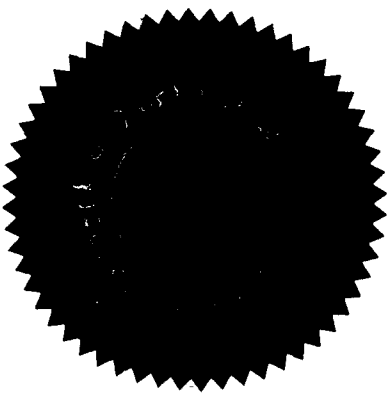


The foregoing order is hereby confirmed
subject to the red ink modifications thereon

[Signature]

An Inspector appointed by The Secretary
of State for Environment, Food and
Rural Affairs

20 JUN 2006

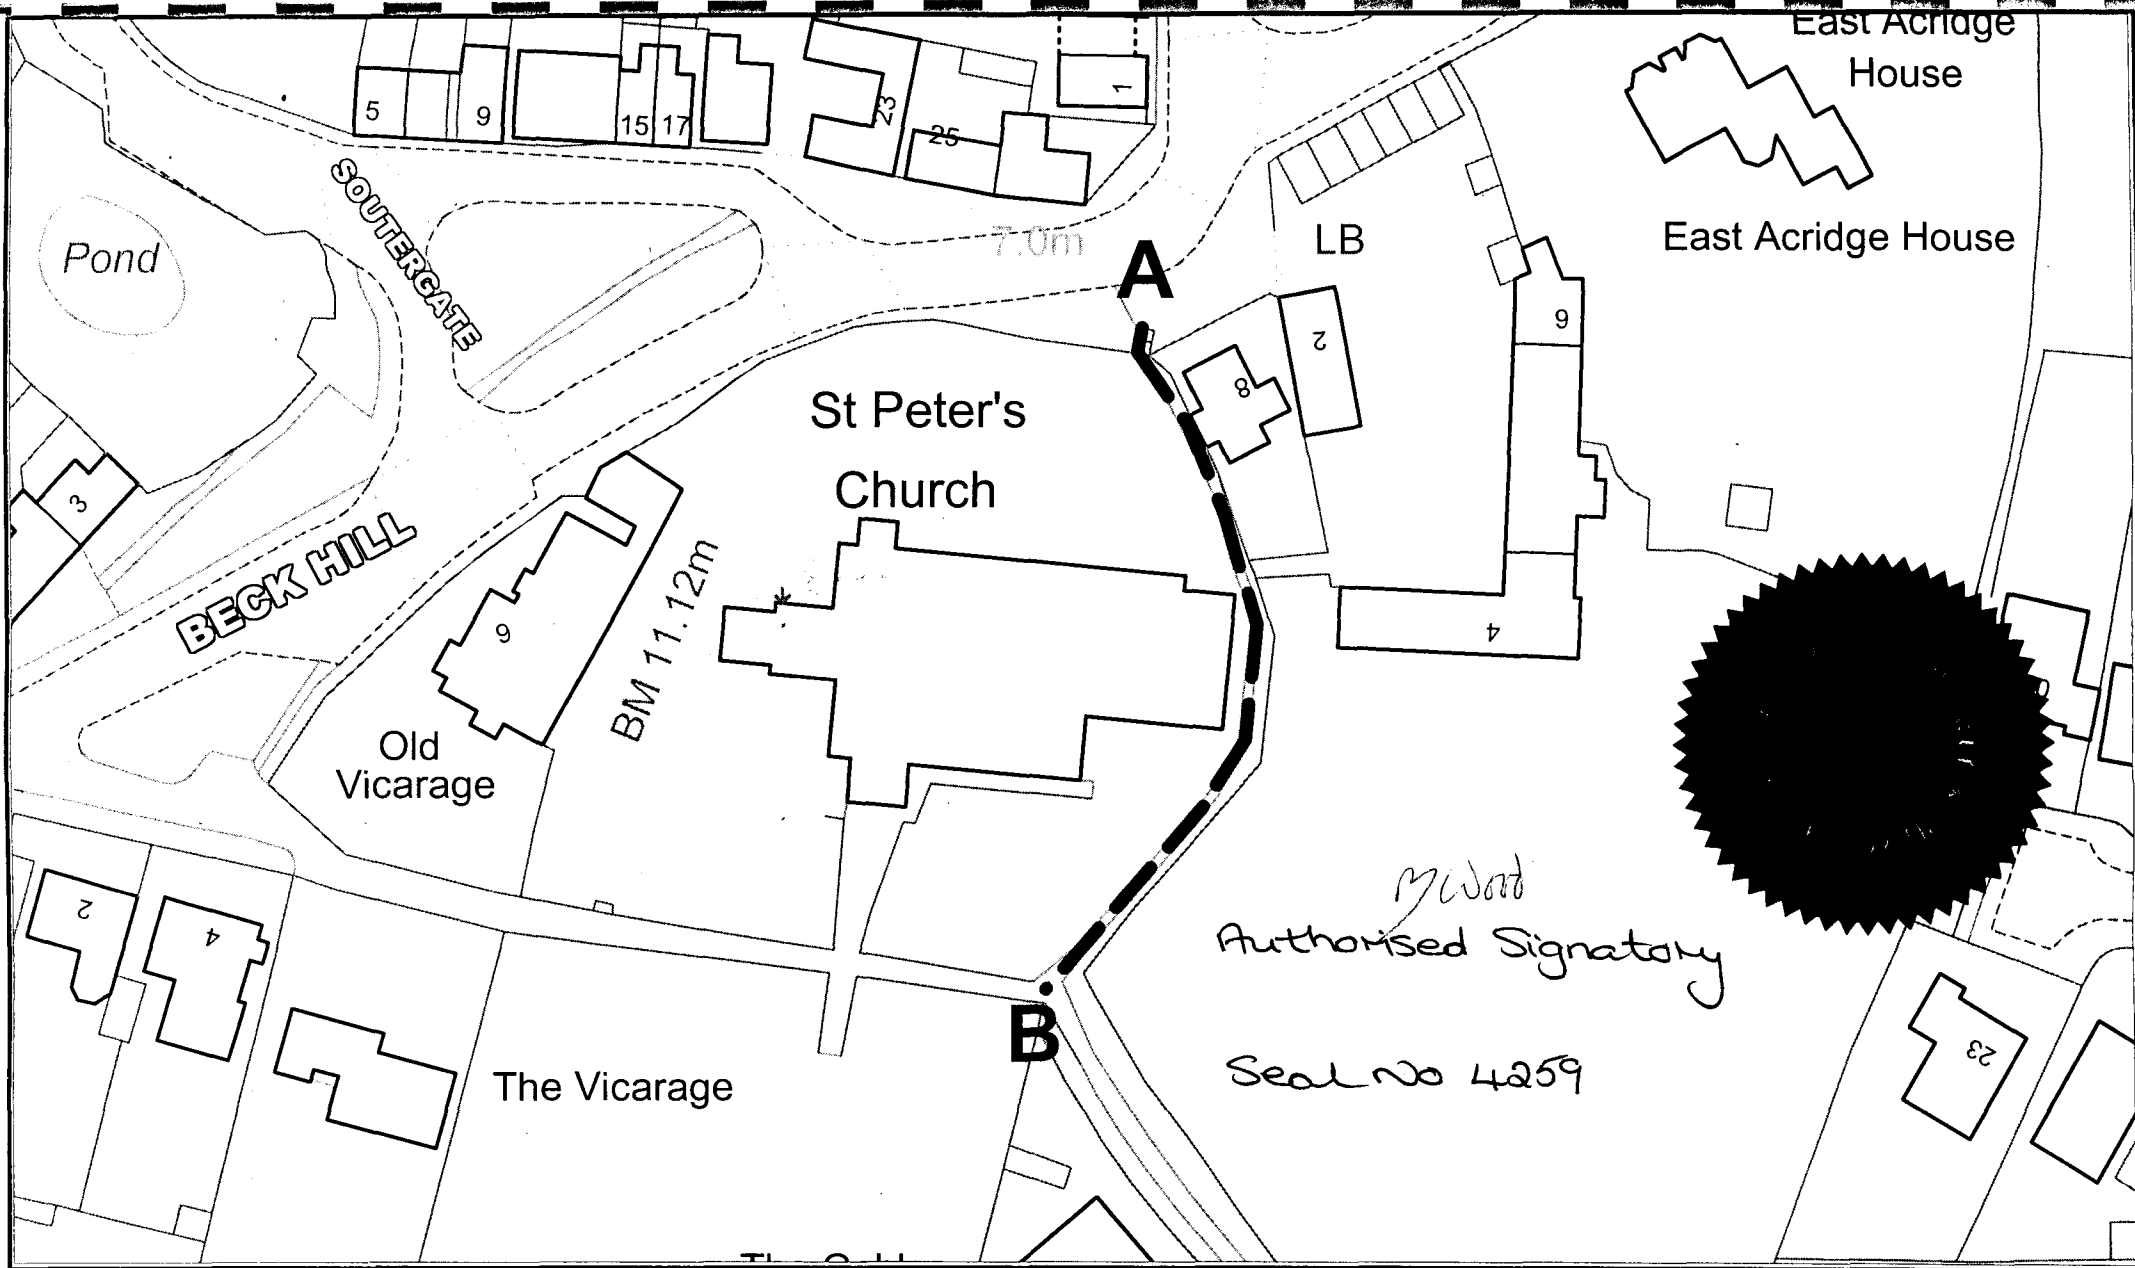

M. Wood
 Authorised Signatory
 Seal No 4259



Based upon the Ordnance Survey mapping with the permission of Ordnance Survey on behalf of the Controller of Her Majesty's Stationery Office.
 © Crown Copyright.

Unauthorised reproduction infringes Crown Copyright and may lead to prosecution or civil proceedings.

NORTH LINCOLNSHIRE COUNCIL 100013349 2004

Drawing Title: Public Footpath 38A, Barton-upon-Humber

Drawn by: CTW

Scale: 1:750

Date: 27/08/2004



Planning and Regeneration Service

Head of Service,
 T Lyman BSc(Hons), DipTP, MRTPI

The Ordnance Survey map data included within this publication is provided by North Lincolnshire Council under license from Ordnance Survey in order to fulfil its public function to act as a planning authority. Persons viewing this mapping should contact Ordnance Survey copyright for advice where they wish to license Ordnance Survey map data for their own use.