

**DEFINITIVE MAP MODIFICATION ORDER  
WILDLIFE AND COUNTRYSIDE ACT 1981**



**PUBLIC FOOTPATH**

**156A Winterton**

*Red Ink  
Modifications*

---

## Wildlife and Countryside Act 1981

### County of Lincoln – Parts of Lindsey (Glanford Brigg) Definitive Map and Statement

#### "Definitive Map Modification (Public Footpath 156A) Order 2006"

This order is made by North Lincolnshire Council under section 53(2)(b) of the Wildlife and Countryside Act 1981 ("the Act") because it appears to that authority that the County of Lincoln - Parts of Lindsey (Glanford Brigg) Definitive Map and Statement require modification in consequence of the occurrence of an event specified in section 53(3)(b) – namely, the expiration, in relation to any way in the area to which the map relates, of any period such that the enjoyment by the public of the way during that period raises a presumption that the way has been dedicated as a public path – of the Act.

The authority have consulted every local authority whose area includes the land to which the order relates. North Lincolnshire Council hereby order that:

1. For the purposes of this order the relevant date is 29<sup>th</sup> December 2006.
2. The County of Lincoln – Parts of Lindsey (Glanford Brigg) Definitive Map and Statement shall be modified as described in Parts I and II of the Schedule and shown on the map attached to the order.
3. This order shall take effect on the date it is confirmed and may be cited as the "Definitive Map Modification (Public Footpath 156A) Order 2006".

#### SCHEDULE

##### PART I

##### Modification of Definitive Map

##### *Description of path to be added*

*A-B, as indicated on the map: A 30 metre-long footpath commencing at grid reference SE93001896 running in a north-westerly direction across a grassed surface to grid reference SE92971898.*

*B-C, as indicated on the map: A 54 metre-long footpath commencing at grid reference SE92971898 running in a south-westerly direction across a grassed surface to the corner of the property at 9 Churchfields at grid reference SE92931894.*

*C-D, as indicated on the map: A 33 metre-long footpath commencing at grid reference SE92931894 running in a southerly direction across a grassed surface at the rear of number 9 Churchfields to grid reference SE92931891.*

*D-E, as indicated on the map: A 56 metre-long footpath commencing at grid reference SE92931891 and proceeding in a south-easterly direction across a grassed surface until it joins the track known as Churchfields at grid reference SE92961886.*

*E-F, as indicated on the map: A 258 metre-long, 5.5 metre wide footpath commencing at grid reference SE92961886 and proceeding along a man-made track known as Churchfields until it reaches its junction with West Street at grid reference SE92951860.*

PART II

Modification of Definitive Statement


*Variation of particulars of path or way*


*A 431 metre-long footpath with a width of 1.8 metres, widening to 5.5 metres commencing at grid reference SE93001896 at the end of the cul de sac known as Mill House Lane, crossing a field in a north-westerly direction to its junction with a school playing field to the east of Winterton Comprehensive School at grid reference SE92971898. Proceeding along the field in south-westerly direction to the north-western corner of the property at number 9 Churchfields at grid reference SE92931894 then turning in a southerly direction running outside the western boundary of the said property continuing through the School field to grid reference SE92931891 before proceeding in a south-easterly direction to grid reference SE92961886 at a point where the track known as Churchfields abuts the School field. Turning in a southerly direction and proceeding for 258 metres along Churchfields to grid reference SE92951860.*

was hereunto affixed  
in the presence of:  
*M Wood*  
(authorised signatory)

Dated: *9th January 2007*

Seal Number: *5358*

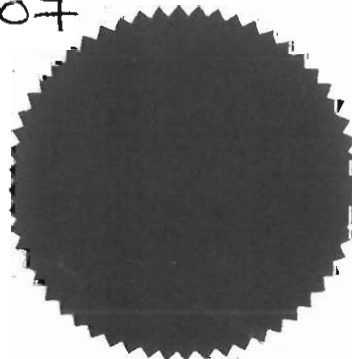

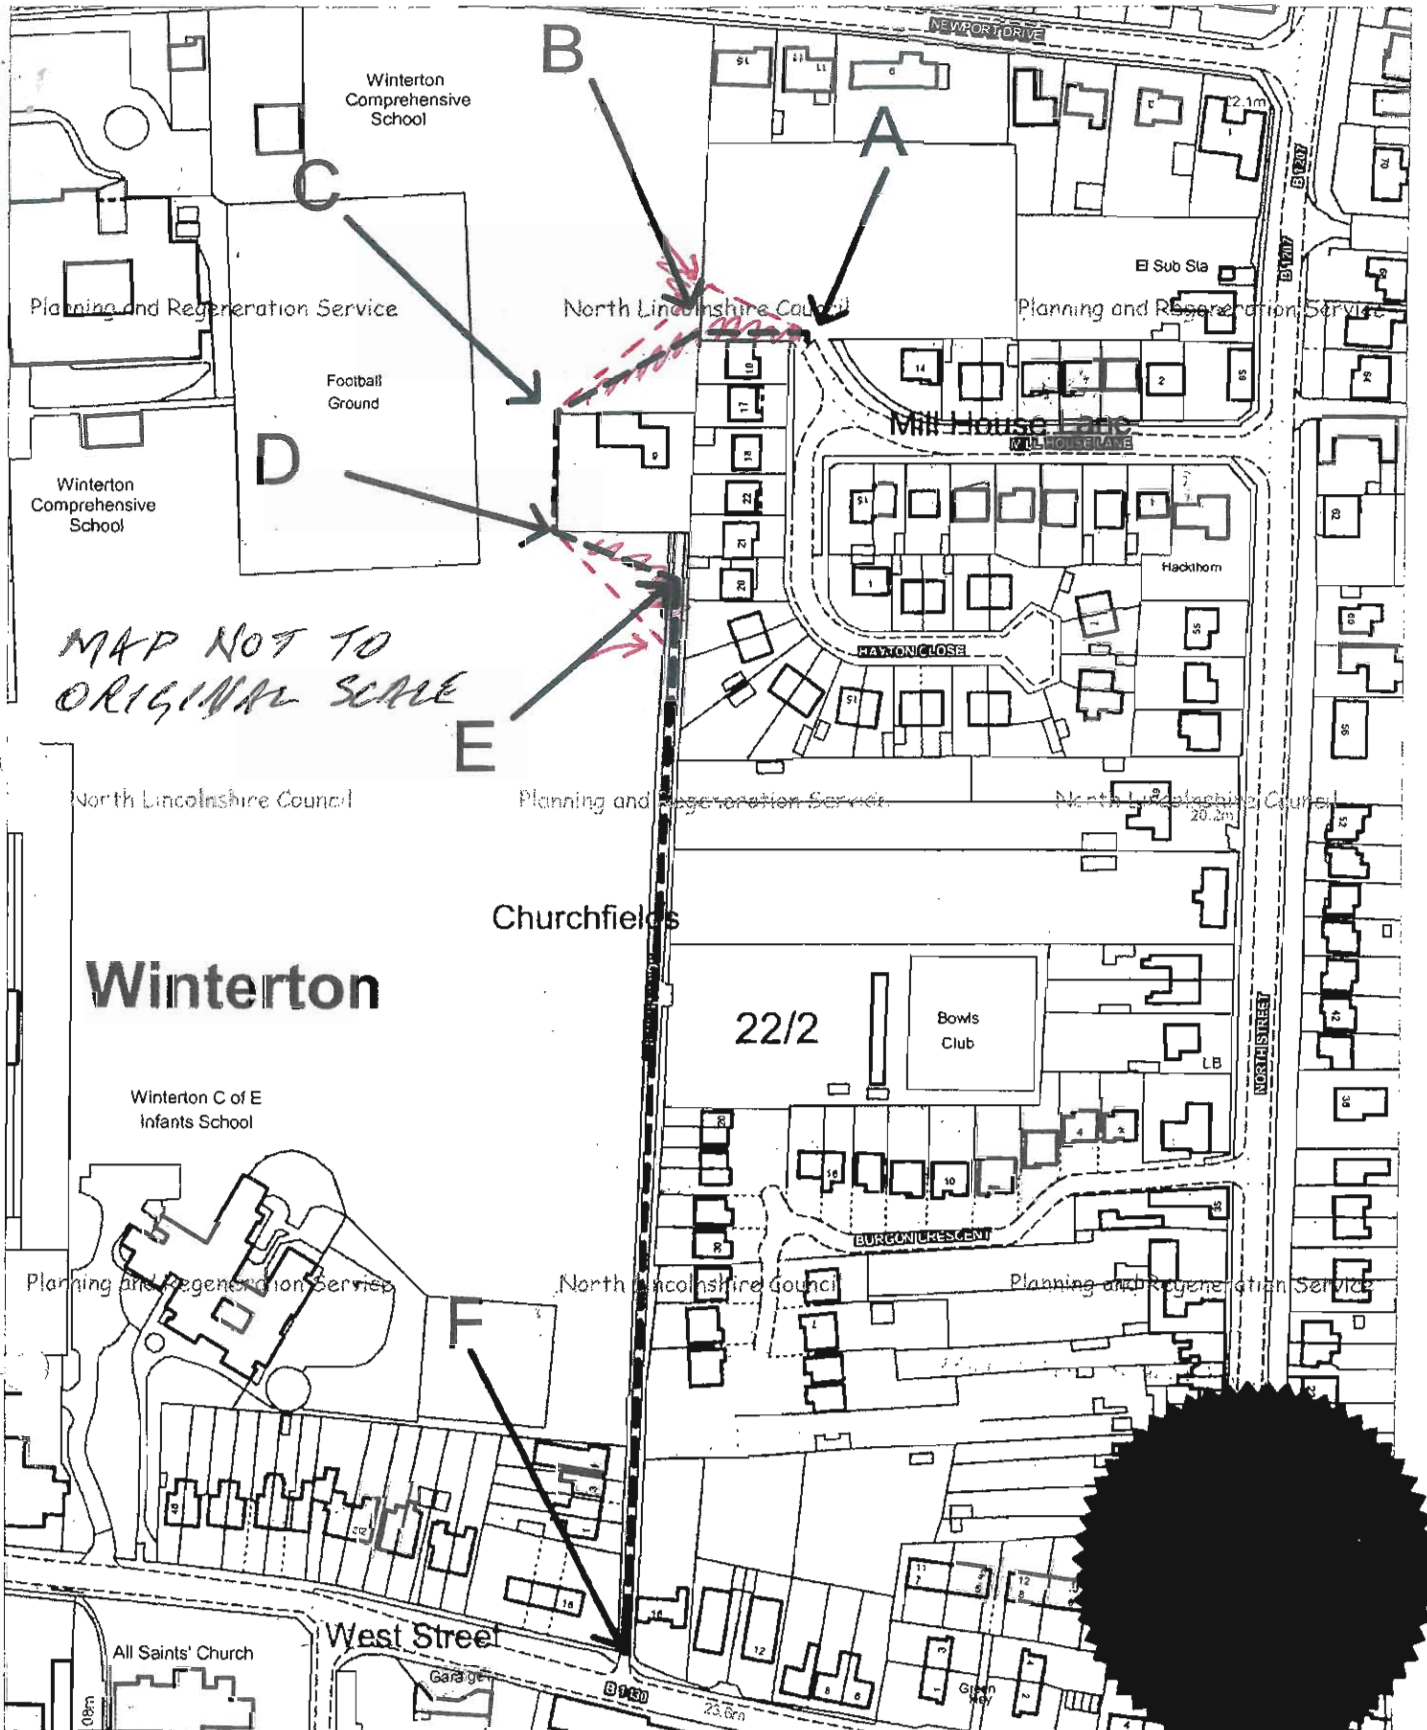

Drawing Title: Winterton 156A

Seal No 5358

OS Grid Ref: SE9295918809

Drawn by: NB

Scale: 1:1,000

Date: 28/12/2006



Based upon the Ordnance Survey mapping with the permission of Ordnance Survey on behalf of the Controller of Her Majesty's Stationery Office. © Crown Copyright.

Unauthorised reproduction infringes Crown Copyright and may lead to prosecution or civil proceedings.

NORTH LINCOLNSHIRE COUNCIL 100013349 2006



Planning and Regeneration Service

Head of Service,

T Lyman BSc(Hons), DipTP, MRTPI

The Ordnance Survey map data included within this publication is provided by North Lincolnshire Council under license from Ordnance Survey in order to fulfil its public function to act as a planning authority. Persons viewing this mapping should contact Ordnance Survey copyright for advice where they wish to license Ordnance Survey map data for their own use.

*Authorised Signatory*